
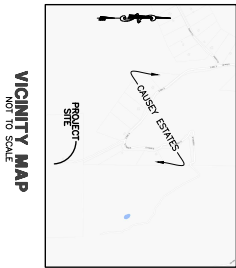



WATER SYSTEM MAP

CAUSEY ESTATES
PART OF SECTION 23, T6N, R3E, SLB4M
WEBER COUNTY, UTAH
OCTOBER 2025

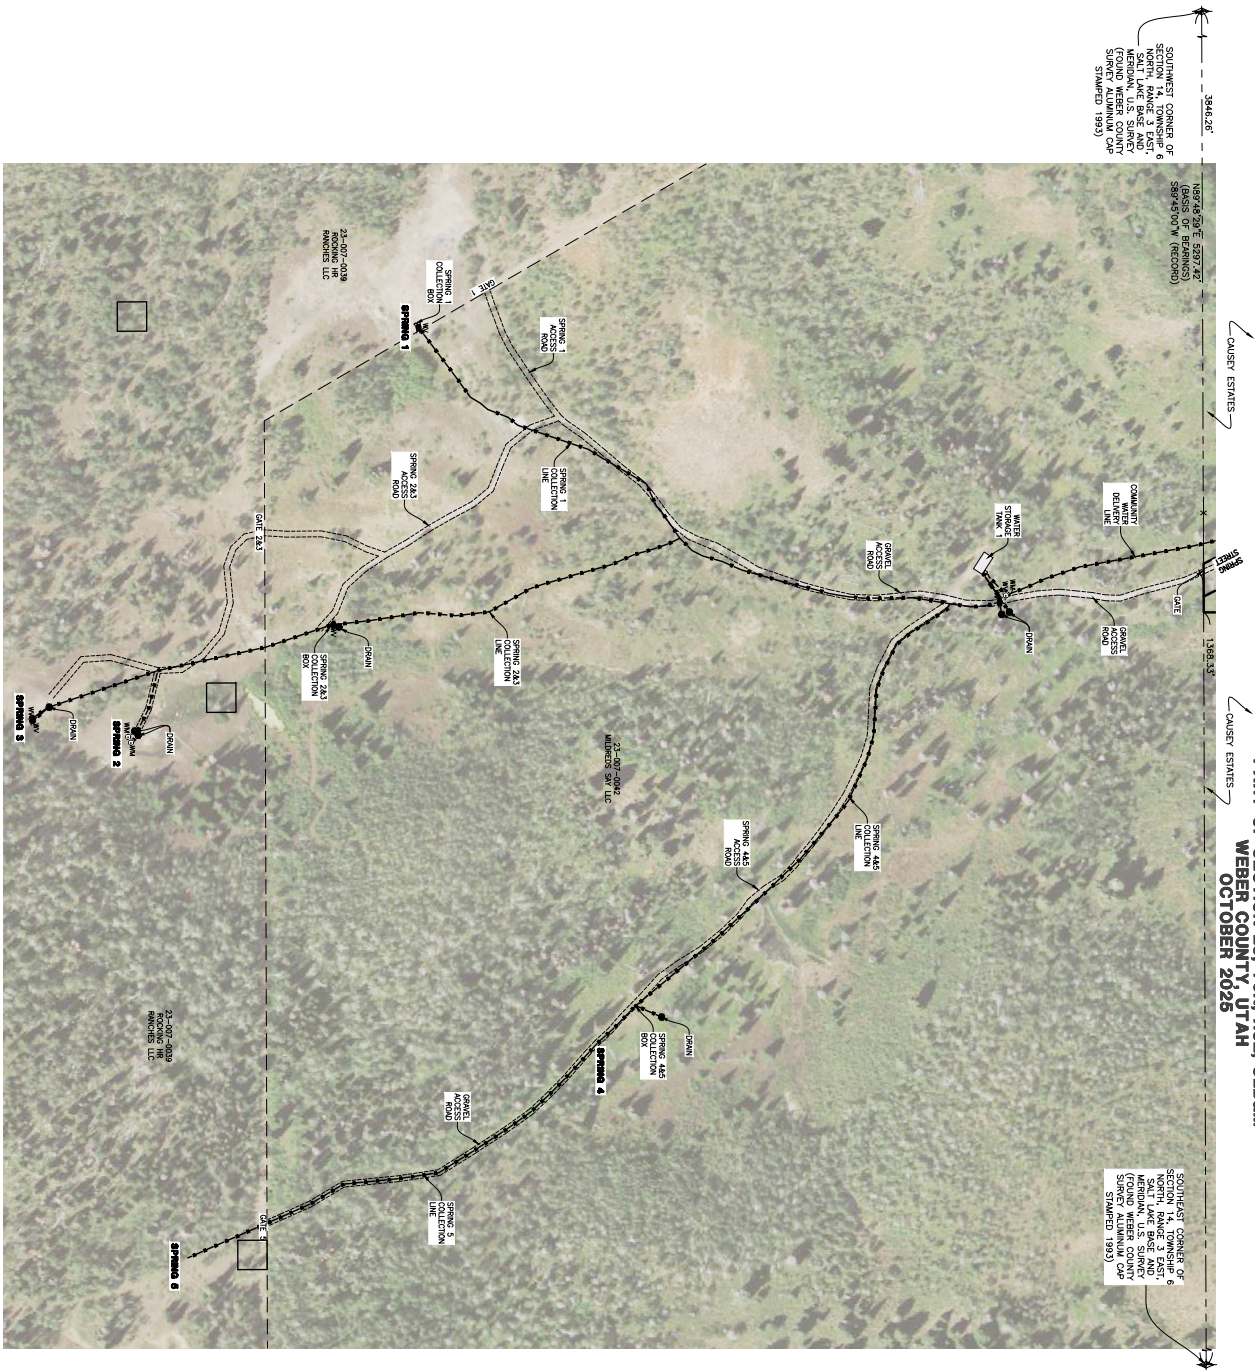

VICINITY MAP
NOT TO SCALE

LEGEND

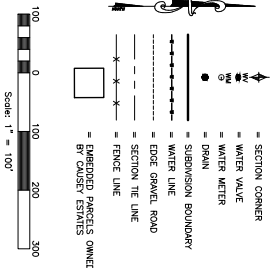

NOTES:

THE CAUSEY ESTATES WATER SYSTEM WAS INSTALLED IN 1971-1972 BY DEVELOPERS BASIN LAND AND LIVESTOCK. THE DIVISION OF DRINKING WATER DEPARTMENT OF THE UTAH DEPARTMENT OF HERITAGE AND ARTS. THE SERVICE BODIES PROVIDES CAUSEY ESTATES ACCESS TO ALL SPRINGS AREAS, FENCES, GRAVEL ROADS AND PROPERTY OWNED BY CAUSEY ESTATES WERE SPRINGS ARE LOCATED.

WATER SYSTEM MAP

WEBER COUNTY, UTAH

CAUSEY ESTATES

DATE	REVISIONS
	DESCRIPTION



Reeve & Associates, Inc.

3000 SOUTH 1000 WEST, RENO, NV 89502
TEL: (775) 821-1000 FAX: (775) 821-1001 WWW.REEVE-ASSOCIATES.COM
LAND SURVEYING • CIVIL ENGINEERING • LANDSCAPE ARCHITECTURE
TRAFFIC ENGINEERING • STRUCTURAL ENGINEERING • LANDSCAPE ARCHITECTS

Project Info.	
Surveyor:	J. FELT
Designer:	J. FELT
Begin Date:	10/20/2025
Name:	M. JENSEN
Scale:	1"=1'
Sheet Number:	8070-02

Sheet	1
Sheets	1